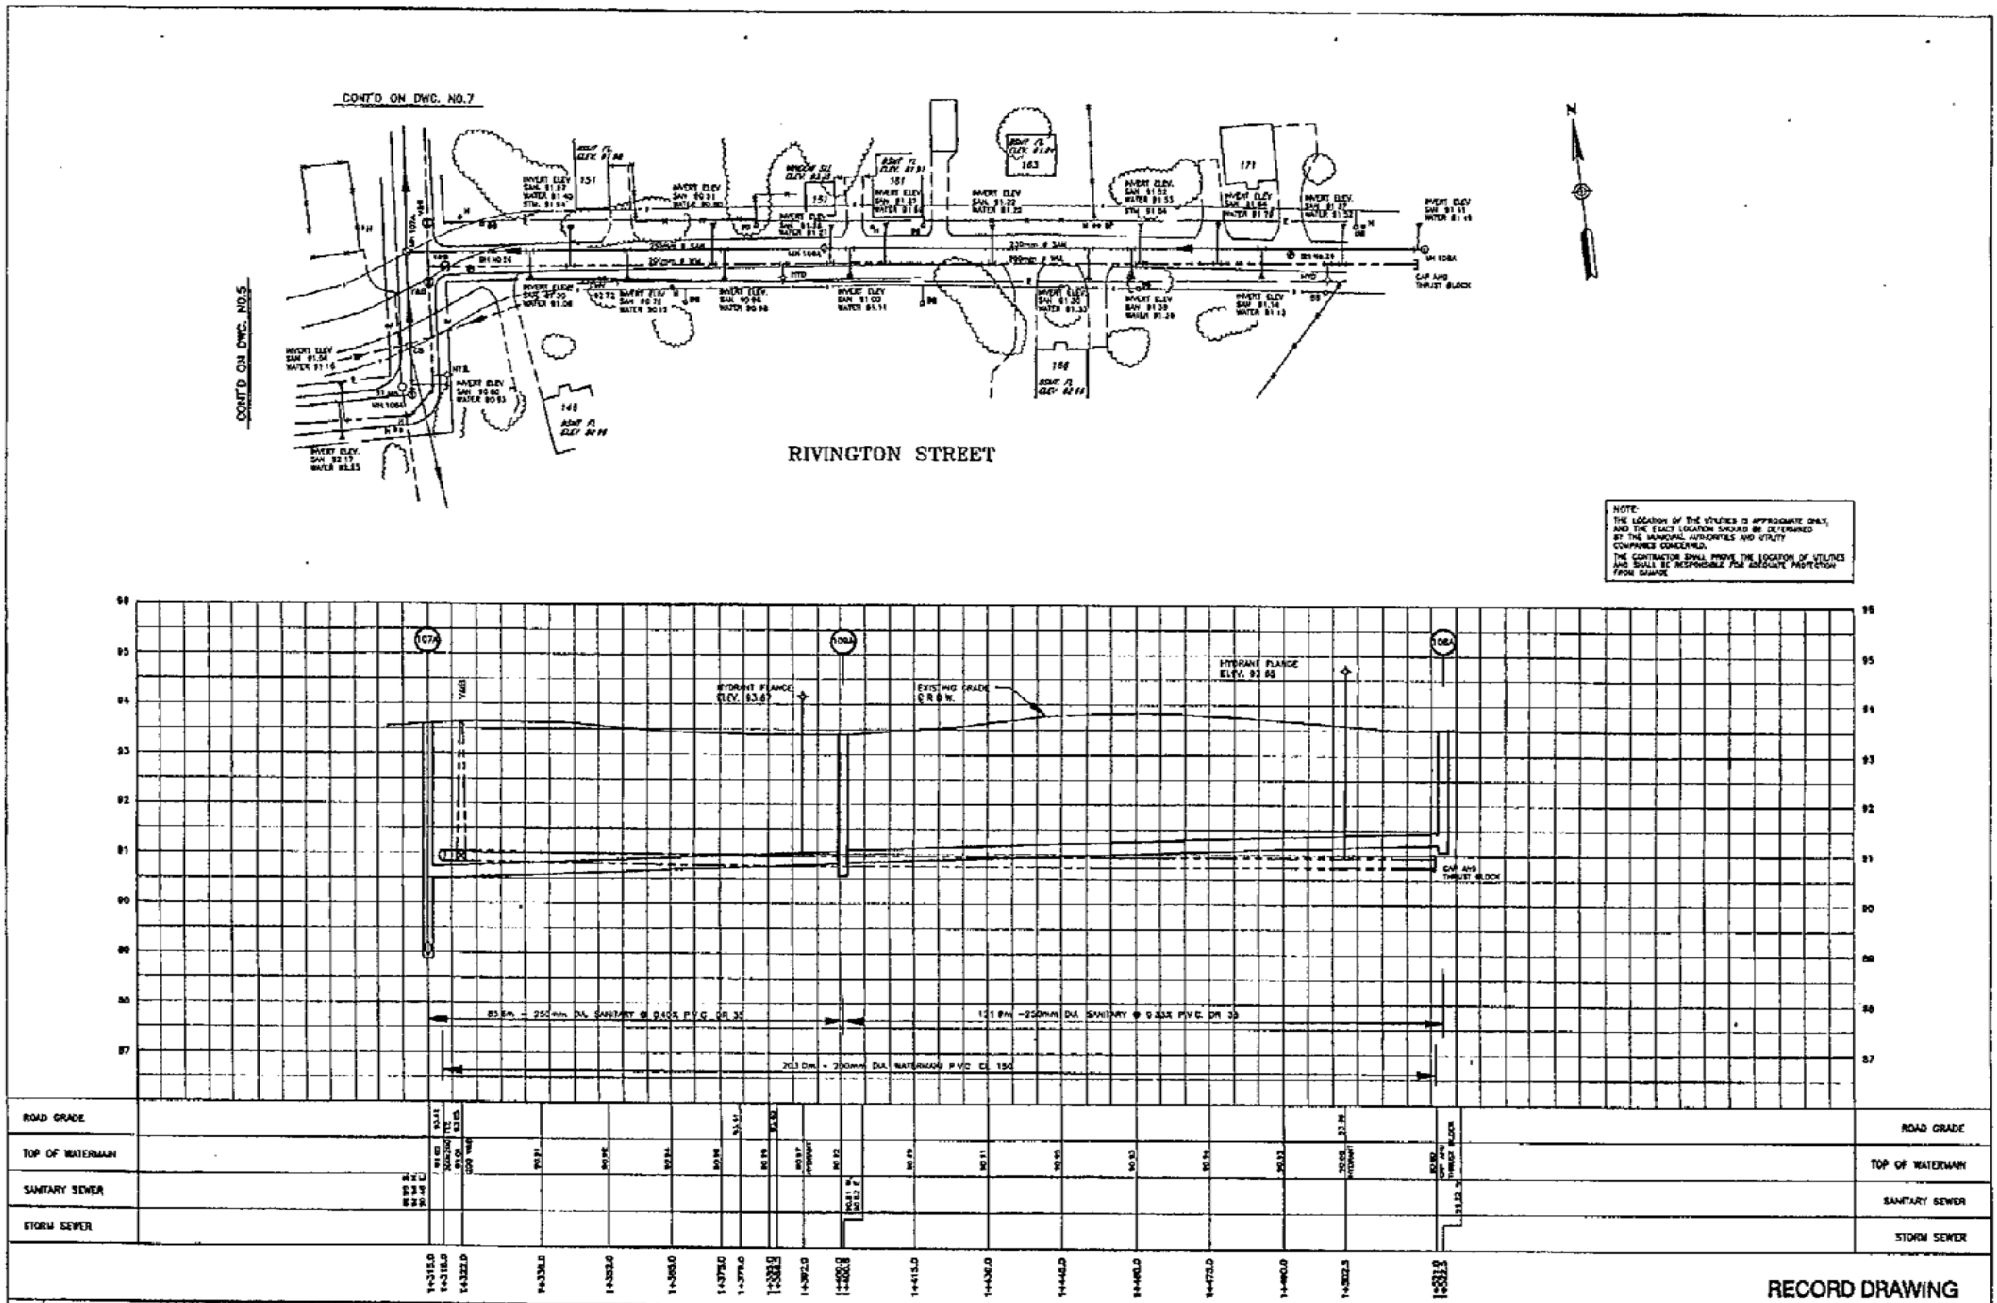

NOTE:
THE LOCATION OF THE UTILITIES IS APPROXIMATE ONLY, AND THE EXACT LOCATION SHOULD BE DETERMINED BY THE MUNICIPAL AUTHORITIES AND UTILITY COMPANIES CONCERNED.
THE CONTRACTOR SHALL PROVE THE LOCATION OF UTILITIES AND SHALL BE RESPONSIBLE FOR ADEQUATE PROTECTION FROM DAMAGE.

RECORD DRAWING

No	Revision	Date	Initial
3	AS RECORDED	JUNE 1995	W.F.
2	AS PER R.M.O.C. COMMENTS	MAY, 1993	B.O.B.
1	AS PER R.M.O.C. GUIDELINES	MAR. 1993	W.F.

SCALE
HORIZONTAL
VERTICAL

KOSTUCH ENGINEERING LIMITED
CONSULTING ENGINEERS
OTTAWA – BROCKVILLE

Village of Carp
Communal Water Supply and Sewage Systems

RIVINGTON STREET
STA. 1+315.0 TO STA. 1+522.5

Regional Municipality of Ottawa – Carleton
Environmental Services Department
Township of West Carleton

Scale HORIZONTAL 1:300 VERTICAL 1:50
Date NOV 1, 1995
Contract No. CS 3075
Drawn by W.FRASER
Chk'd by C.COTTRELL
Dwg No 2316/17 – 6

8609